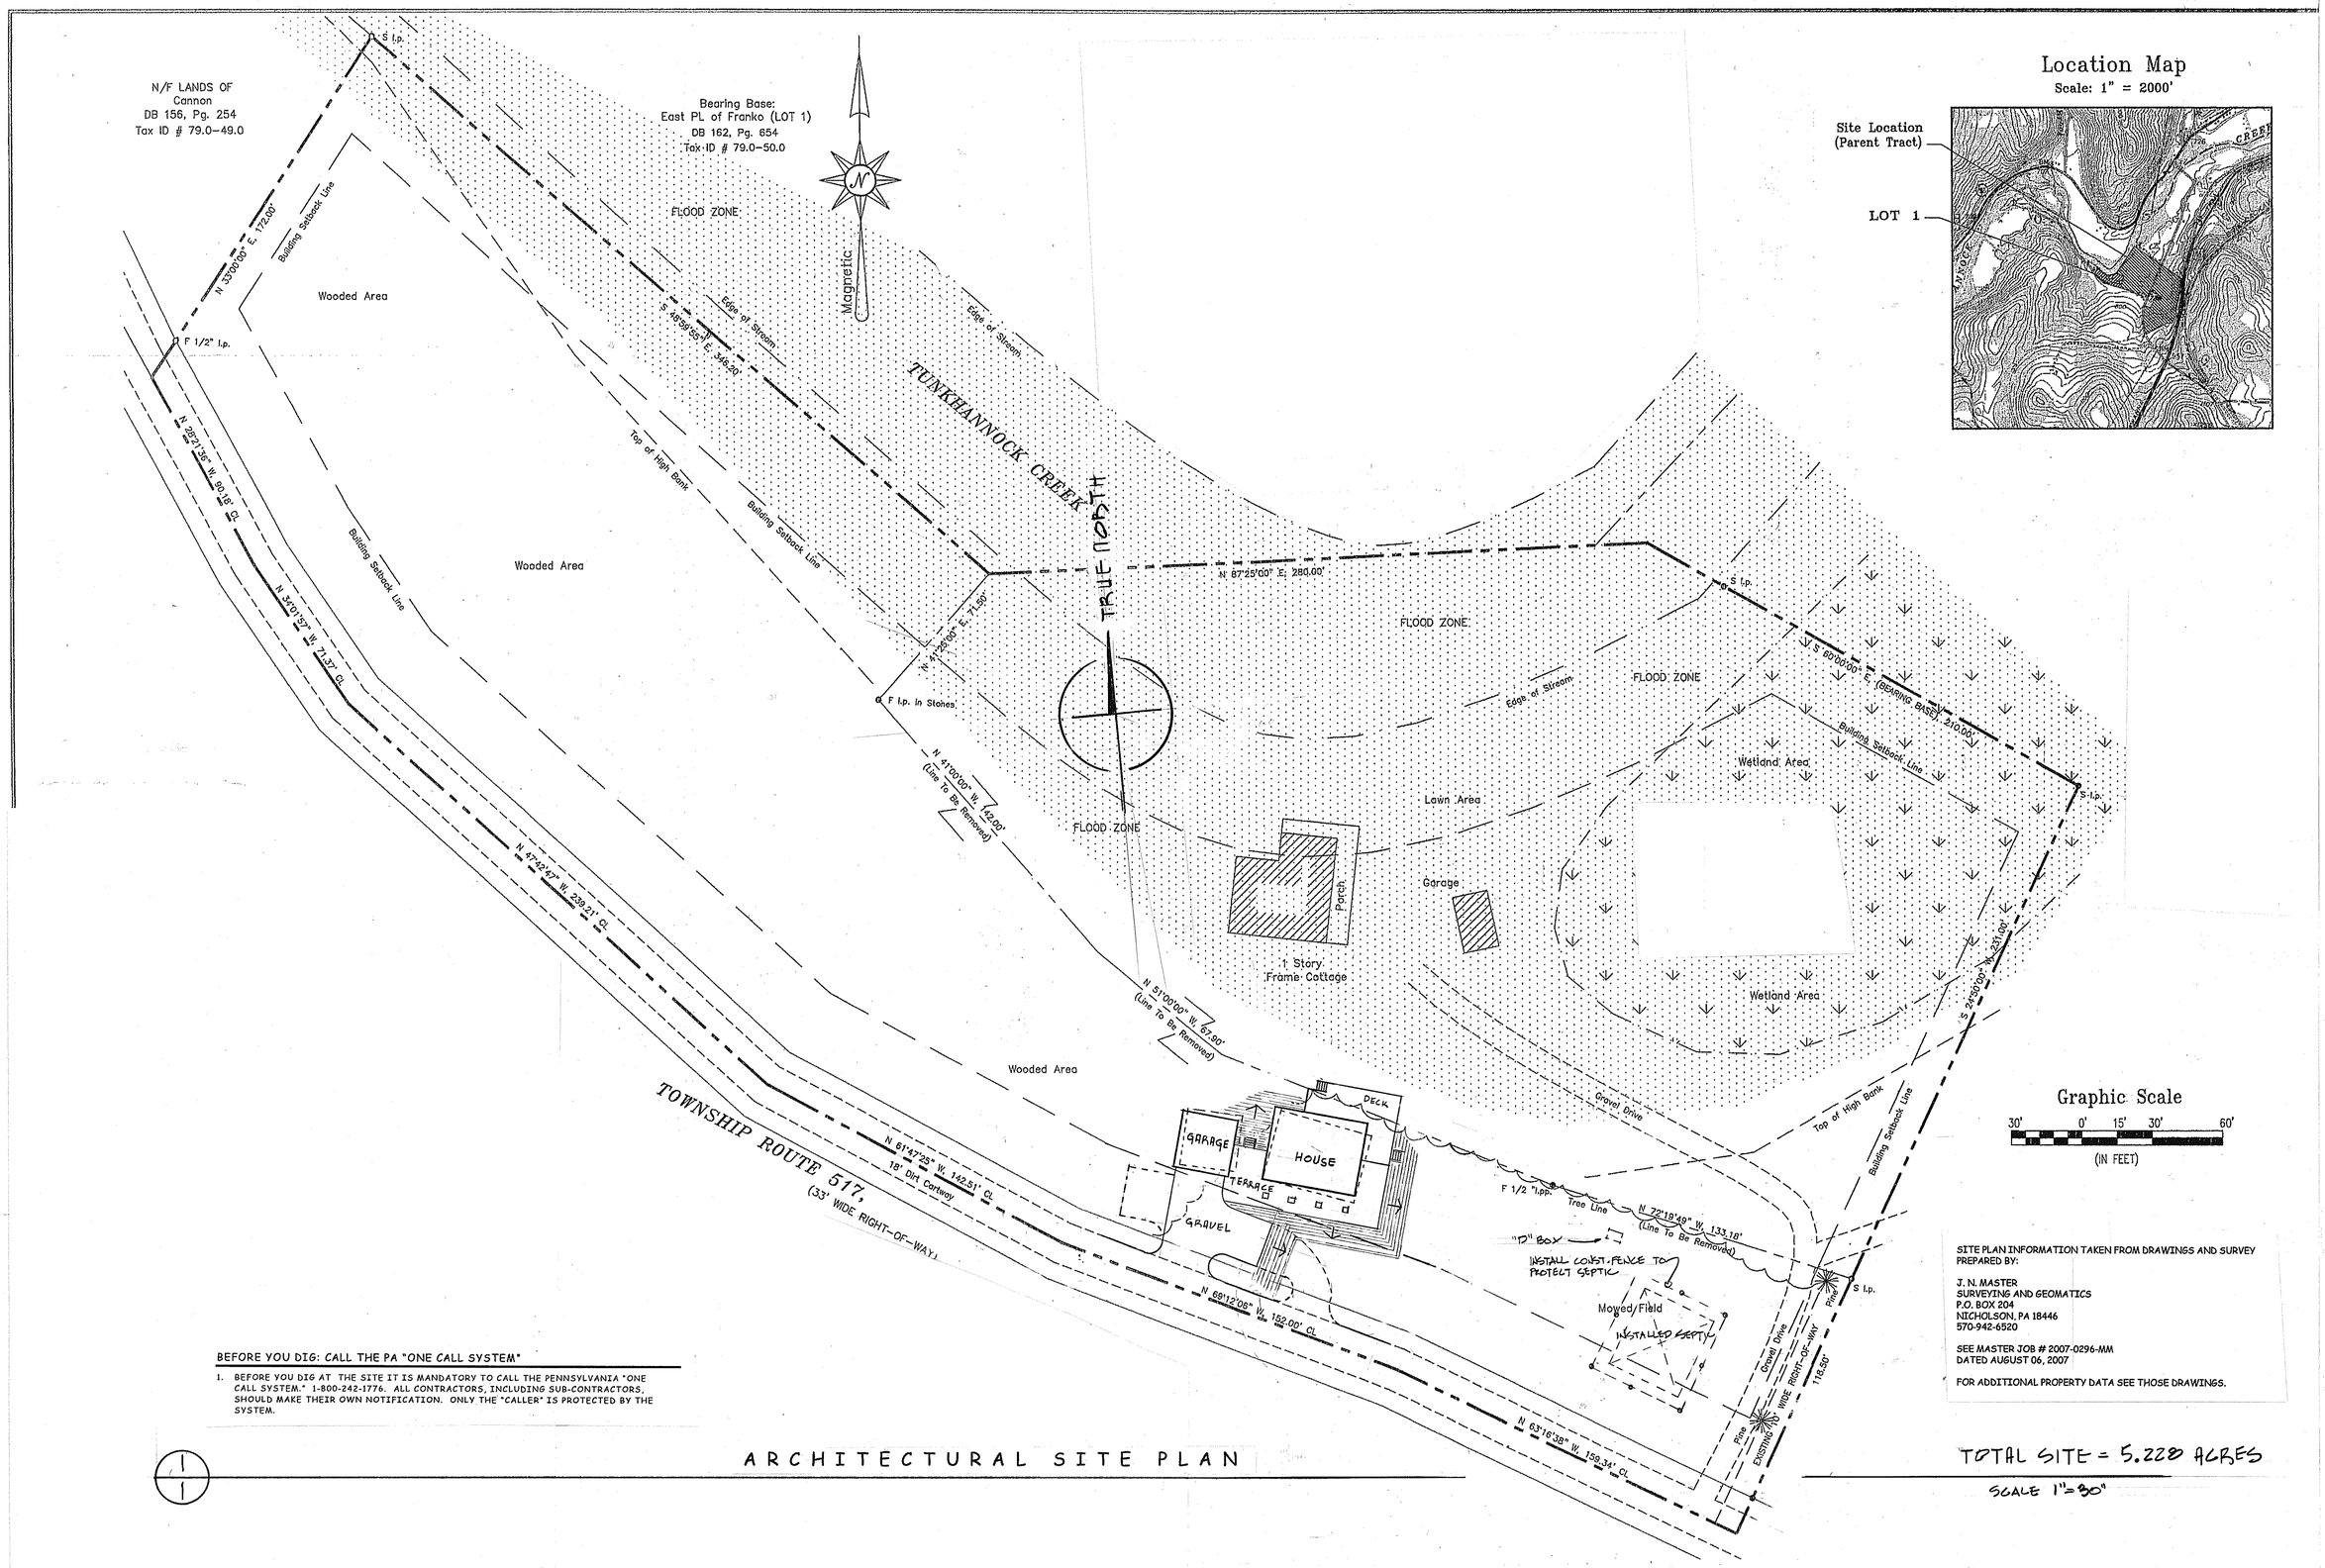

SITE PLAN INFORMATION TAKEN FROM DRAWINGS AND SURVEY PREPARED BY:

J. N. MASTER
SURVEYING AND GEOMATICS
P.O. BOX 204
NICHOLSON, PA 18446
570-942-6520

SEE MASTER JOB # 2007-0296-MM
DATED AUGUST 06, 2007

FOR ADDITIONAL PROPERTY DATA SEE THOSE DRAWINGS.

BEFORE YOU DIG: CALL THE PA "ONE CALL SYSTEM"

1. BEFORE YOU DIG AT THE SITE IT IS MANDATORY TO CALL THE PENNSYLVANIA "ONE CALL SYSTEM." 1-800-242-1776. ALL CONTRACTORS, INCLUDING SUB-CONTRACTORS, SHOULD MAKE THEIR OWN NOTIFICATION. ONLY THE "CALLER" IS PROTECTED BY THE SYSTEM.

1/1

ARCHITECTURAL SITE PLAN

TOTAL SITE = 5.228 ACRES

SCALE 1"=30'

REV #	REVISION DESCRIPTION	DATE
	START UP	FEB. 05, 2011
	PRELIMINARY	NOV. 16, 2011
	ESTIMATING & TRADE INPUT	DEC. 16, 2011
	~~PERMIT SUBMISSION~~ REVIEW	FEB. 05, 2012
	~~P-S-~~ PERMITS	FEB. 20, 2012
		JULY 12, 2012

ONLY VALID FOR PERMITS w/ EMBOSSED SEAL & ORIGINAL "RED" SIGNATURE

HOUSE & GARAGE ARE BOTH PRESENTED IN THIS SET OF DRAWINGS, HOWEVER WILL BE SEPARATE PROJECTS.

Eric C. Van Reed Architect
Creative Design Associates, Inc.
ARCHITECTURE INTERIORS SITE & SPACE PLANNING
350 Callowhill Road
Chalfont, PA 18914
Voice: 215-672-1155
www.ArchitectVision.com

ACHITECTURAL SITE PLAN

NEW PRIVATE RESIDENCE
TAMARACK ROAD
NICHOLSON TWP, WYOMING CO., PENNSYLVANIA
DEED BOOK 162, PAGE 654, TAX ID # 79.0-50.0, 5.228 ACRES

Sheet No.
1
of 11

Comm. No.
2011-2924